

LOG OF PILE 15e

DRAWING NO. 22

SHEET NO. 1


PROJECT NO. 01019
 PROJECT MAGISTRATES COURT & POLICE STATION
 DATE 29 - Jul 2008
 WEATHER -

SPLIT SPOON SAMPLE
 AUGER SAMPLE
 SPT (N) VALUE
 DYNAMIC CONE TEST
 SHELBY TUBE
 SHEAR STRENGTH TEST
 VANE TEST

LOG

NATURAL MOISTURE CONTENT
 ATTERBERG LIMITS
 UNDRAINED TRIAXIAL AT % STRAIN AT FAILURE
 PENETROMETER TEST

LOG

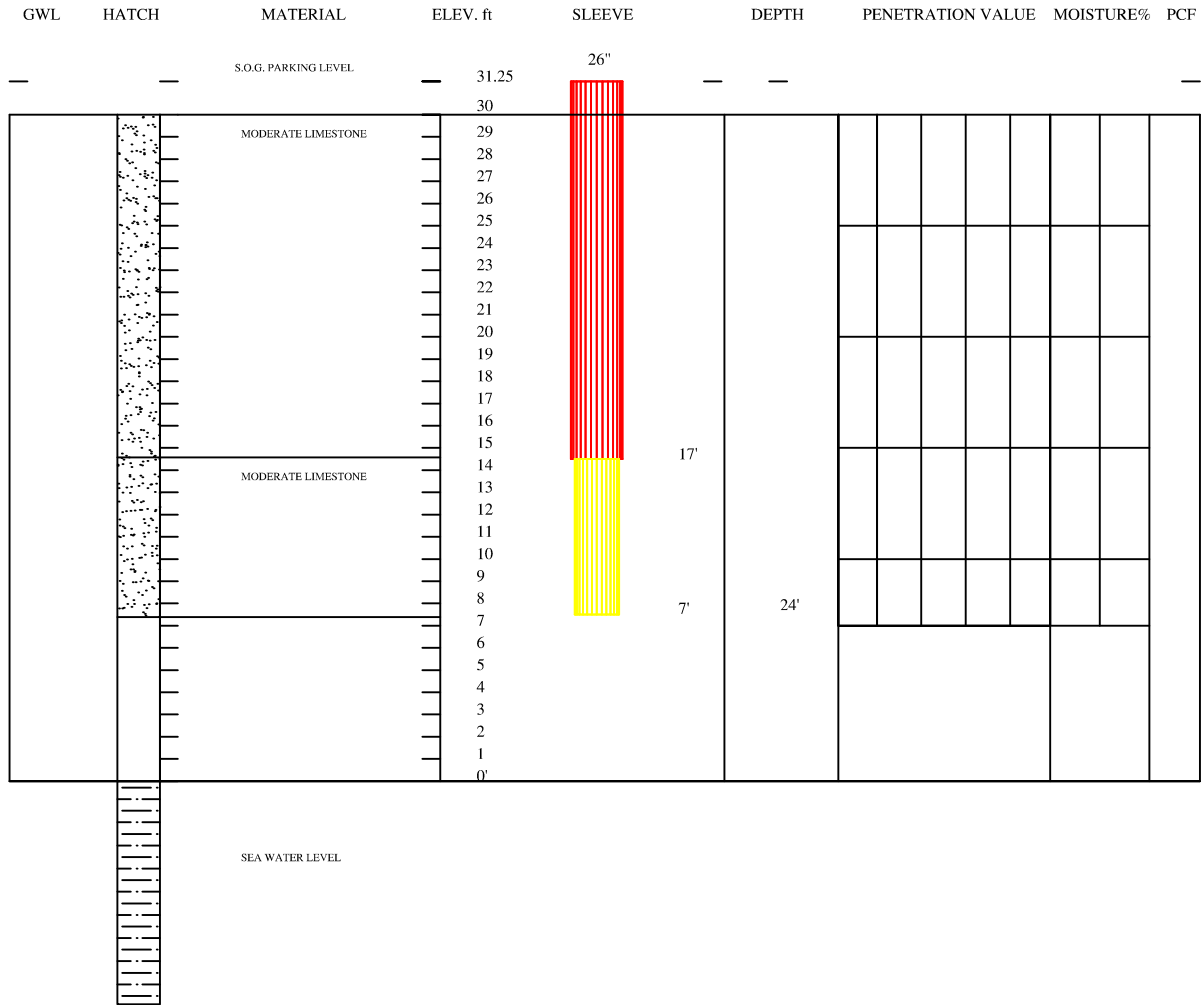

ALL WORKS RECORDED WILL BE CROSS REFERENCED AND VERIFIED TO THE AS BUILT DRAWING.

CONSULTANT SIGNATURE _____

WITNESS SIGNATURE _____